



圖例
LEGEND

Pecked Red Line



施工區界線
LIMIT OF WORKS AREA



地段界線
LOT BOUNDARY

D.D.

丈量約份
DEMARCATIION DISTRICT

RP

餘段
REMAINING PORTION


S.

分段
SECTION

Pecked Red Line

紅色虛線
PECKED RED LINE

在圖則編號 YLM 11066 (第三張) 內所顯示的土地名稱須予修訂。
The designation of the land as shown on Plan No. YLM11066 (Sheet 3) shall be modified.

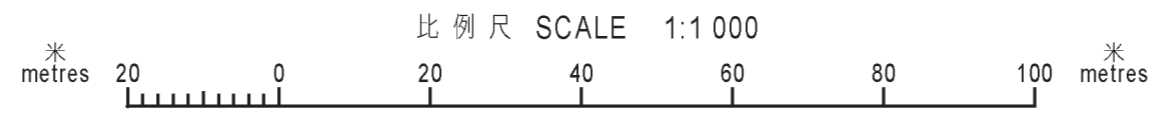

只作識別用 FOR IDENTIFICATION PURPOSES ONLY

已簽署 Signed

(劉燕儀 Joanne LOU)
總產業測量師 / 新發展區 Chief Estate Surveyor / New Development Area
日期 Date 12/04/2024

地政總署新發展區組
New Development Area Section
Lands Department
圖則由元朗測量處繪製
Plan Prepared by District Survey Office, Yuen Long
© 香港特別行政區政府 版權所有 Copyright reserved - Hong Kong SAR Government

修改收地圖則
水污染管制 (排污設備) 規例 (第 358 章, 附屬法例 AL) 第 26 條
引用道路 (工程、使用及補償) 條例 (第 370 章)
工務計劃項目第 7827CL 號 (部分) 及第 4429DS 號
元朗南第二期發展及元朗南淨水設施的排污設備工程
MODIFICATION RESUMPTION PLAN
ROADS (WORKS, USE AND COMPENSATION) ORDINANCE (CHAPTER 370)
AS APPLIED BY SECTION 26 OF THE WATER POLLUTION CONTROL (SEWERAGE) REGULATION
(CHAPTER 358, SUBSIDIARY LEGISLATION AL)
PWP ITEM NOS. 7827CL (PART) AND 4429DS
SEWERAGE WORKS UNDER YUEN LONG SOUTH DEVELOPMENT - SECOND PHASE DEVELOPMENT AND
YUEN LONG SOUTH EFFLUENT POLISHING PLANT

檔案編號 File No. LD NDA/YLS/PLAN/3, LD DSO/YL/13/157/2
測量圖編號 Survey Sheet No. 6-NW-19A
參考圖編號 Reference Plan No. 60630968/GAZ/136 (土木工程拓展署 CEDD)
圖則編號 PLAN No. YLM11378